LABOR AND MATERIALS

1	Copper / ~~Lead~~ Connection 3/4	$ 1.31
1	Curb { Cock / Valve / T. S. & V. } 3/4 in.	$ 1.75
1	Service Box Old returned { Short 3½x4½ / Long 4½x5½ / Buff. or Rdway }	$ 1.60
9	Ft. 3/4 in. { Copper / Galv Iron / Cast Iron } Pipe at 18	$ 1.62
	Nipples ____ in. at	$
	Bushings ____ to ____ in. at	$
	Red'g / Inc'g Couplings ____ to ____ in. at	$
	Union ____ in. at	$
	Meter ____ in. at	$
	Lead Joints at	$
	Leadite Joints at	$
	Hrs. Foreman at	$
3	Hrs. Chauffeur at 62½	$ 1.88
½	Hrs. Tapper at	$
2	Hrs. Labor at	$ .90
	Hrs. Labor at	$
	Hrs. Compressor at	$
	Compensation Ins.	$ .09
	Trucking	$ 1.—
	Builders Use of Water hopatch	$ —
Tap by Hess		$
		$
		$
		$
		$ 10.15

B & F - 1940

St. Pl. Ave. No. 70

Third St

Name of Owner

Ball

Labor and Mat'l. Report Aug 23 1940

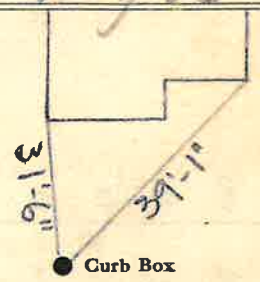

6 Main

Elev. of Main at tap 4½

Gate at ● ● Gate at

¾" Copper 9' to main

● Curb Box

TAX ID# 309.11-5-56