Labor and Materials

1	Copper Lead	Connection 3/4	$ 2.60
1	Curb Cock Valve T. S. & V.	in. 3/4	$ 2.27
1	Service Box Old returned ~~Short 3½x4½~~ Long 4½x5½ ~~Buffalo Rodway~~		$ 1.59
23	Ft. in. Copper ~~Galv. Iron~~ Cast Iron	Pipe at	$ 4.14
	Nipples in. at		$
	Bushings to in. at		$
	Red'g Inc'g Couplings to in. at		$
	Union in. at		$
	Meter in. at		$
	Lbs. Br. Stone at		$
	Lbs. Sand at		$
	Bags Cement at		$
	Paving Brick Mack Red Asphalt	at	$
	Lead Joints at		$
	Leadite Joints at		$
1	Hrs. Foreman at		$ 1.75
16	Hrs. Common Labor at		$ 7.20
	Hrs. Common Labor at		$
	Hrs Mason at		$
	Hrs Mason's Helper at		$
	Hrs. Compressor at		$
	Compensation Ins		$ .26
	Trucking		$ 1.—
	Builders' Use of Water Batch		$ 5.—

Total $ 25.31

31-138

Labor and Material Report Sept. 7 19 71

~~410~~ Fluid St.

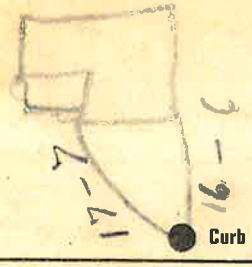

6 Main — Elev of Main at tap 6

Gate at ● — ● Gate at 23' to MAIN

● Curb Box

Old tap dis-
connected.

TAX ID# 309.12-138