LABOR AND MATERIALS

1	Copper / Lead Connection 3/4	$ 2.87
1	Curb { Cock / ~~Valve~~ / T. S. & V. } 3/4 in.	3.62
1	Service box { Short 3½X4½ / Long 4½X5½ / Buff or Rdway } Old returned	4.68
25 Ft. 3/4 in.	{ Copper / G. I. / C. I. } Pipe at 37	8.00
	Nipples ..... in. at	
	Bushings ..... to ..... in. at	
	Red'g Inc'g { Coupl'gs ..... to ..... in. at	
	Union ..... in. at	
	Meter ..... in. at	
	Lead Joints at	
	Compound Joints at	
	Hrs. Water Maint. Man—1 at	
1	Hrs. Water Maint. Man—2 at 1.07	1.07
1	Hrs. Labor— ....at 91	.91
	Hrs. Labor— ....at	
	Hrs. Compressor at	
	Compensation Ins. at $ ..... per C	.04
	Trucking	2.—
	Pav't Patch	
	Tapping Machine	
	O'head	
		$ 23.14

51

~~St.~~ ~~Pl.~~ Third St Ave. No. 90

Name of Owner

Crystal Wallace

Labor and Mat'l. Report May 18 19 49

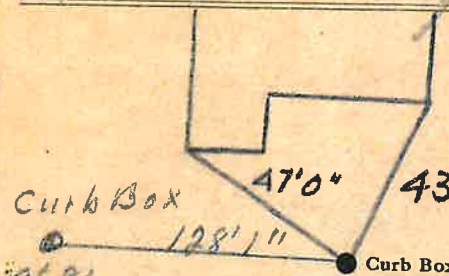

a/86

6 Main

Elev. of Main at tap 6

Gate at ● ● Gate at

25' to main

● Curb Box

TAX ID# 309.11-9-3

LSM-5C 5 15-48