LABOR AND MATERIALS

1	Copper / ~~Lead~~ Connection	3/4"	$ 2.29
1	Curb — Cock / ~~Valve~~ / ~~T. S. & V.~~	3/4" in.	$ 2.70
1	Service box — ~~Old returned~~ — Short 3½x4½ / Long ~~4½x5½~~ / Buff or Rdway		$ 4.25
15 Ft.	3/4 in. — Copper / ~~C. I.~~ / ~~C. I.~~ Pipe at	35	$ 5.25
	Nipples	in. at	$
	Bushings	to in. at	$
	Red'g / Inc'g Coupl'gs	to in. at	$
	Union	in. at	$
	Meter	in. at	$
	Lead Joints at		$
	Compound Joints at		$
	Hrs. Water Maint. Man—1 at		$
2	Hrs. Water Maint. Man—2 at	1.02	$ 2.04
2	Hrs. Labor— at	91	$ 1.82
	Hrs. Labor— at		$
	Hrs. Compressor at		$
	Compensation Ins. at $ per C.		$ .09
	Trucking		$ 1.06
	Pav't Patch Outside		$
	Tap by Warsinski		$
			$
			$
	O'head		$
			$ 19.44

St.
~~Pl.~~
~~Ave.~~ No. Thomas

Name of Owner
George Decker

Labor and Mat'l. Report Aug 24 1950

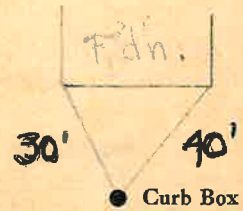

12" Main — Elev. of Main at tap 5'

Gate at ● — ● Gate at

3/4" Copper — 15' to MAIN

● Curb Box

LSM-6C 10-21-49