## LABOR AND MATERIALS

| | | |
|---|---|---|
| 1 | Copper / ~~Lead~~ Connection 3/4 | $ 2.87 |
| 1 | Curb Cock / ~~Valve~~ / ~~T. S. & V.~~ 3/4 in. | $ 3.62 |
| 1 | Service box / ~~Old returned~~ ~~Short 3½X4½~~ / Long 4½X5½ / Buff or Rdway | $ 4.68 |
| 9 | Ft. 3/4 in. Copper / ~~G. I.~~ / ~~C. I.~~ Pipe at 32 | $ 2.88 |
| | Nipples ..... in. at | $ |
| | Bushings ..... to ..... in. at | $ |
| | Red'g / Inc'g Coupl'gs ..... to ..... in. at | $ |
| | Union ..... in. at | $ |
| | Meter ..... in. at | $ |
| | Lead Joints at | $ |
| | Compound Joints at | $ |
| | Hrs. Water Maint. Man—1 at | $ |
| 2 | Hrs. Water Maint. Man—2 at 1.02 | $ 2.04 |
| | Hrs. Labor— ..... at | $ |
| | Hrs. Labor— ..... at | $ |
| | Hrs. Compressor at | $ |
| | Compensation Ins. at $2.18 per C | $ .04 |
| | Trucking | $ 2.00 |
| | Pav't Patch | $ |
| | Taply Magnum | $ |
| | | $ |
| | | $ |
| | O'head | $ |
| | | $ 18.13 |

88

St.
~~Pl.~~
Ave. No.

Thomas

Name of Owner

W. Griffin

Labor and Mat'l. Report Aug 15 1949

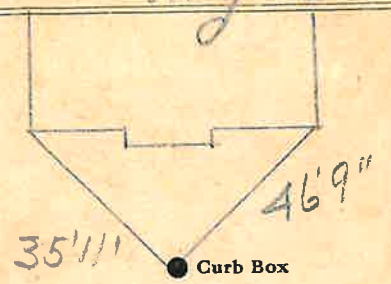


12 Main

Elev. of Main at tap 5

Gate at ● ● Gate at

3/4" Copper 9' to main

● Curb Box

LSM-5C 5 15-48