LABOR AND MATERIALS

1	Copper / ~~Lead~~ Connection 3/4"		$ 2.29
1	Curb { Cock / ~~Valve~~ / ~~T. S. & V.~~ } 3/4 in.		$ 2.70
1	Service box / ~~Old returned~~ { Short 3½x4½ / ~~Long 4½x5½~~ / Buff or Rdway }		$ 4.25
9	Ft. 3/4 in. { Copper / ~~G. I.~~ / ~~C. I.~~ } Pipe at 35		$ 3.15
	Nipples in. at		$
	Bushings to in. at		$
	Red'g / Inc'g { Coupl'gs to in. at		$
	Union in. at		$
	Meter in. at		$
	Lead Joints at		$
	Compound Joints at		$
	Hrs. Water Maint. Man—1 at		$
3	Hrs. Water Maint. Man—2 at	1.02	$ 3.06
3	Hrs. Labor— at	91	$ 2.73
	Hrs. Labor— at		$
	Hrs. Compressor at		$
	Compensation Ins. at $ per C.		$ 13
	Trucking		$ 1.—
	Pav't Patch		$
	Tap by Maguin		$
			$
			$
	O'head		$
			$ 19.31

NW Cor Third 2-3-1950 ✓

St. ~~Pl.~~ Ave. No. 9

Thomas

Name of Owner

Wm Trembley

Labor and Mat'l. Report Aug 8 1950

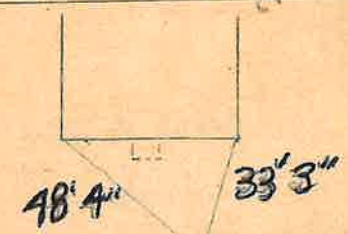

12" Main

Elev. of Main at tap 5'

Gate at ● 3/4" Copper

● Gate at 9' to main

● Curb Box

TAX ID# 309.11-1-54

LSM-5C 10-21-49