LABOR AND MATERIALS

1	Copper / ~~Lead~~ Connection	3/4	$ 2.87
1	Curb — Cock / ~~Valve~~ / ~~T. S. & V.~~	3/4 in.	$ 3.62
1	Service box — ~~Old returned~~ — Short ~~3½X4½~~ / Long 4½X5½ / Buff or Rdway		$ 4.68
9	Ft. 3/4 in. — Copper / ~~G. I.~~ / ~~C. I.~~ — Pipe at 37		$ 2.88
	Nipples ..... in. at		$
	Bushings ..... to ..... in. at		$
	Red'g / Inc'g Coupl'gs ..... to ..... in. at		$
	Union ..... in. at		$
	Meter ..... in. at		$
	Lead Joints at		$
	Compound Joints at		$
	Hrs. Water Maint. Man—1 at		$
3	Hrs. Water Maint. Man—2 at	1.02	$ 3.06
	Hrs. Labor— ....at		$
	Hrs. Labor— ....at		$
	Hrs. Compressor at		$
	Compensation Ins. at $2.18 per C		$ .07
	Trucking		$ 2.00
	Pav't Patch		$
Tap by Main			$
			$
			$
	O'head		$
			$ 19.18

77

St.
~~Pl.~~
~~Ave.~~ No. 15

Thomas

Name of Owner

Cook

Labor and Mat'l. Report July 19 1949

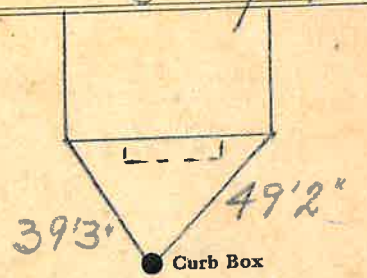

12 Main

Elev. of Main at tap 5"

Gate at ● ● Gate at

3/4" Copper 9' to main

● Curb Box

TAX ID # 309.11-1-67

Q bury

L9M-5C 5 15-48