Labor and Materials

..... Copper / Lead	Connection	$
..... Curb	Cock / Valve / T. S. & V. ..... in	$
..... Service Box / ~~Old returned~~	Short 3½ x 4½ / Long 4½ x 5½ / ~~Buff. or Rdway~~	$
..... Ft. ..... in.	Copper / Galv Iron / Cast Iron Pipe at	$
..... Nipples	in. at	$
..... Bushings	to ..... in. at	$
Red'g / Inc'g	Conplings ..... to ..... in. at	$
..... Union	in. at	$
..... Meter	in. at	$
..... Lead Joints at		$
..... Leadite Joints at		$
..... Hrs. Foreman at		$
..... Hrs, Chauffeur at		$
..... Hrs. Tapper at		$
..... Hrs. Labor at		$
..... Hrs. Labor at		$
..... Hrs. Compressor at		$
..... Compensation Ins.		$
..... Trucking		$
..... Builders Use of Water		$
		$
		$
		$
		$
		$

Thomson ~~St.~~ ~~Pl.~~ Ave. No. 31 32

Name of Owner

TAX ID # 302.16-1-9

Labor and Mat'l. Report 19

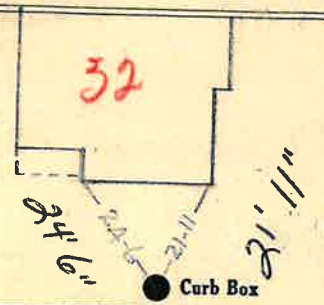

..... Main

Elev. of Main at tap .....

Gate at ●

● Gate at

● Curb Box