LABOR AND MATERIALS

1 Copper / ~~Lead~~ Connection 3/4		$ 1.80
1 Curb { Cock / ~~Valve~~ / ~~T. S. & V.~~ } 3/4 in.		$ 1.96
1 Service Box Old returned { Short 3½x4½ / Long 4½x5½ / ~~Buff or Rdway~~ }		$ 1.82
30 Ft. 3/4 in. { Copper / ~~Galv Iron~~ / ~~Cast Iron~~ } Pipe at 19		$ 5.70
Nipples in. at		$
Bushings to in. at		$
Red'g / Inc'g } Couplings to in. at		$
Union in. at		$
Meter in. at		$
Lead Joints at		$
Leadite Joints at		$
Hrs. Foreman at		$
28 Hrs. Chauffeur at	68 3/4	$ 19.25
Hrs. Tapper at		$
Hrs. Labor at		$
Hrs. Labor at		$
Hrs. Compressor at		$
Compensation Ins.		$ .51
Trucking		$ 1.00
Builders Use of Water		$ 11.70
Tap by Warsinski		$
		$
		$
		$
		$ 43.74

J-14

~~St.~~ ~~Pl.~~ Ave. No. ~~14~~ 19

Thomson

Name of Owner

Durant

Labor and Mat'l. Report Sept 27 1944

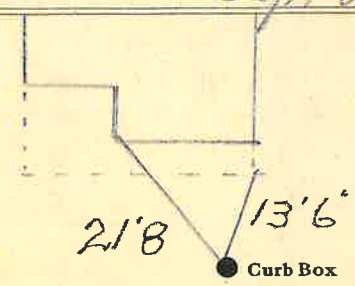

6 Main

Elev. of Main at tap 6½

Gate at ● ● Gate at

3/4" copper 30' to main

● Curb Box

TAX ID# 302.16-3-6