LABOR AND MATERIALS

1 Copper / ~~Lead~~ } Connection 3/4" MARK II $

1 Curb { Cock / ~~Valve~~ / ~~T. S. & V.~~ } 3/4 in. ORIGINAL $

1 Service box / Old returned { ~~Short 3½ x 4½~~ / Long 4½ x 5½ / ~~Buff or Rdway~~ } $

12 Ft. 3/4 in. { Copper / G. I. / C. I. } Pipe at $

Nipples in. at $

Bushings to in. at $

Red'g / Inc'g } Coupl'gs to in. at $

Union in. at $

Meter in. at $

Lead Joints at $

Compound Joints at $

Maintenance Foreman $

Hrs. Water Maint. Man—1 at $

Hrs. Water Maint. Man—2 at $

Hrs. Garage Foreman at $

Hrs. Labor— at $

Hrs. Compressor at $

Compensation Ins. at $ per C $

Trucking $

Pav't Patch $

$

TAP Made By ROCK & Co $

$

O'head April-20-1972 $

$

St. Pl. Ave. No. 16 THORN BERRY DR

Name of Owner TAX ID # 309.15-8-58 John C. Hughes

Labor and Mat'l. Report April 20 19 72

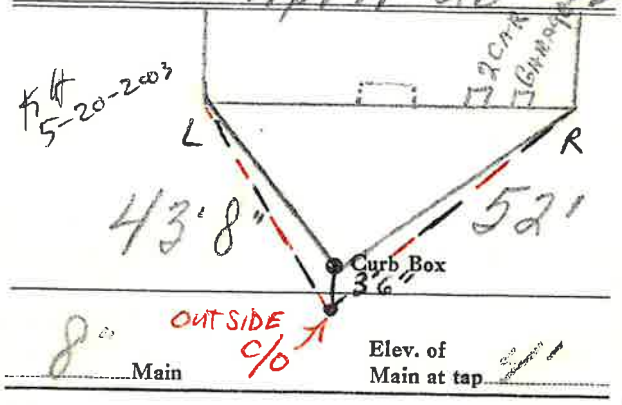

OUTSIDE CLEAN OUT IS 3'6" FROM CURB BOX.

LEFT - 47'

RIGHT - 56'

INSTALLED 5-20-2003

LSM—5C—6-1-67