## Labor and Materials

| | | | |
|---|---|---|---|
| 1 | Copper Lead — Connection | ¾ | $ 1.46 |
| 1 | Curb — Cock / Valve / T. S. & V. | 3/4 in | $ 1.93 |
| 1 | Service Box — Old returned — Short 3½ x 4½ / Long 4½ x 5½ / Buff. or Rdway | 1 | $ 1.77 |
| 12 | Ft. ¾ in. — Copper / Galv Iron / Cast Iron — Pipe at 22 | | $ 2.64 |
| | Nipples ..... in. at ..... | | $ |
| | Bushings ..... to ..... in. at ..... | | $ |
| | Red'g Inc'g — Couplings ..... to ..... in. at ..... | | $ |
| | Union ..... in. at ..... | | $ |
| | Meter ..... in. at ..... | | $ |
| | Lead Joints at ..... | | $ |
| | Leadite Joints at ..... | | $ |
| | Hrs. Foreman at ..... | | $ |
| 6 | Hrs. Chauffeur at 6.2½ | | $ 3.75 |
| 8 | Hrs. Tapper at ..... | | $ 5.00 |
| 8 | Hrs. Labor at 45 | | $ 3.60 IV.35 |
| | Hrs. Labor at ..... | | $ |
| | Hrs. Compressor at ..... | | $ |
| | Compensation Ins. ..... | | $ .38 |
| | Trucking ..... | | $ 1.00 |
| | Builders Use of Water Patch | | $ 5.00 |
| | ..... | | $ |
| | ..... | | $ |
| | Tap by Hasse | | $ |
| 1 | | | $ 26.53 |

OCT 2 - 1937

#19

St. Pl. Ave. Trask No. 44

**Name of Owner**

Lincham

**Labor and Mat'l. Report** Nov 6 1937

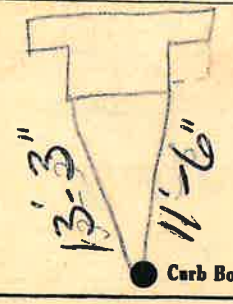


2 Gal Main

Elev. of Main at tap

Gate at 3/4 Copper

Gate at 12' to main

Curb Box

old Shut-off

TAX ID # 303.17-1-28