LABOR AND MATERIALS

1 Copper / ~~Lead~~	Connection 3/4	$ 1.35
1 Curb { ~~Cock~~ / ~~Valve~~ / ~~T. S. & V.~~ }	3/4 in.	$ 1.80
1 Service Box / ~~Old returned~~	{ Short 3½x4½ / ~~Long 4½x5½~~ / ~~Buff or Rdway~~ }	$ 1.70
23 Ft. 3/4 in.	{ ~~Copper~~ / ~~Galv Iron~~ / ~~Cast Iron~~ } Pipe at 18	$ 4.14
Nipples ... in. at		$
Bushings ... to ... in. at		$
~~Red'g~~ / ~~Inc'g~~ Couplings ... to ... in. at		$
Union ... in. at		$
Meter ... in. at		$
Lead Joints at		$
Leadite Joints at		$
Hrs. Foreman at		$
3 Hrs. Chauffeur at	62½	$ 1.87
8 Hrs. Tapper at	"	$ 5.1
8 Hrs. Labor at	45	$ 3.60
Hrs. Labor at		$
14½ Hrs. Compressor at	.62½	$ .94
Compensation Ins.		$ 3%
Trucking		$ 1.—
Builders Use of Water	½ Patch (Sewer)	$ 2.50
Tap by Hosser		$
		$
		$
		$
		$ 24.26

~~F~~ 7 5 1941

8

St.
~~Pl.~~
Ave. No. 10

Travel

Name of Owner

Leonard

Labor and Mat'l. Report July 10 1941

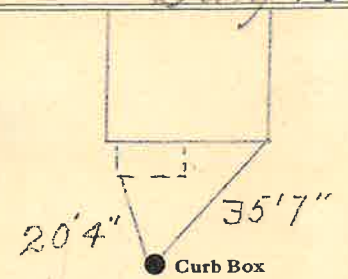

6" C. I. 1965

4 Gal / Main

Elev. of Main at tap 6½

Gate at ● ● Gate at

3/4" Copper 23' to main

● Curb Box

TAX ID # 303.17-8-3