LABOR AND MATERIALS

Copper / Lead	Connection	$
Curb	Clock / Valve / T. S. & V. ... in.	$
Service box / Old returned	Short 3½X4½ / Long 4½X5½ / Buff or Rdway	$
Ft. ... in.	Copper / Galv. Iron / Cast Iron — Pipe at	$
Nipples	in. at	$
Bushings	to ... in. at	$
Red'g / Inc'g	Couplings ... to ... in. at	$
Union	in. at	$
Meter	in. at	$
Lead Joints at		$
Compound Joints at		$
Hrs. Foreman at		$
Hrs. Chauffeur at		$
Hrs. Tapper at		$
Hrs. Labor at		$
Hrs. Labor at		$
Hrs. Compressor at		$
Compensation Ins.		$
Trucking		$ 1.—
Builders Use of Water		$
		$
		$
		$
		$
		$

17-7-47

St. ?
Pl.
Ave. No. 15E

Tremont

Name of Owner
Alexander Williams

Labor and Mat'l. Report Sept 18 1947

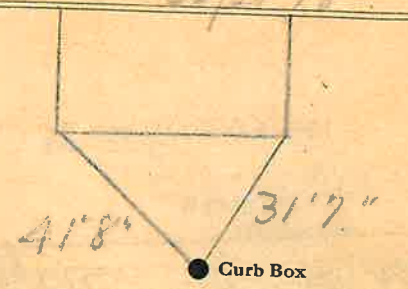

6 Main

Elev. of Main at tap 5

Gate at

Gate at

Curb Box

TAX ID # 309.16-17-8

LSM-5C-6-1-45