LABOR AND MATERIALS

1	Copper Lead — Connection	3/4"	$ 3.04
1	Curb — Cock / Valve / T. S. & V.	3/4 in.	$ 3.54
1	Service box — Short 3½x4½ / Long 4½x5½ / Buff or Rdway — Old returned		$ 4.70
14	Ft. 3/4 in. — Copper / G. I. / C. I. — Pipe at 35		$ 4.90
	Nipples in. at		$
	Bushings to in. at		$
	Red'g / Inc'g — Coupl'gs to in. at		$
	Union in. at		$
	Meter in. at		$
	Lead Joints at		$
	Compound Joints at		$ 13.96
	Hrs. Water Maint. Man—1 at		$
	Hrs. Water Maint. Man—2 at		$
3	Hrs. ~~Labor~~ AM at	1.26	$ 3.78
10	Hrs. Labor— at	1.02	$ 10.20
	Hrs. Compressor at		$
	Compensation Ins. at $ 2.66 per C.		$ .37
	Trucking		$ 1.00
	Pav't Patch		$
			$
			$
			$
	O'head		$
			$ 31.53

Tap by Gifford
5-15-51

St. Pl. Ave. No. East Fremont 42

Name of Owner
Warrington

Labor and Mat'l. Report 5 - 15 - 1951

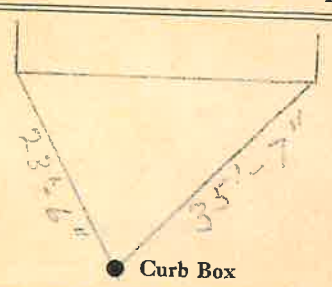

6" Main — Elev. of Main at tap 5'

Gate at ● — ● Gate at

3/4 Copper — 14' to main

● Curb Box

Tap on Faxon St.

TAX ID # 309.16-15-7

LSM-SC 10-21-49