LABOR AND MATERIALS

1	Copper / ~~Lead~~ Connection	3/4	$ 2.94
1	Curb — Cock / Valve / T. S. & V.	3/4 in.	$ 3.71
1	Service box — Old returned — Short 3½X4½ / Long 4½X5½ / Buff or Rdway		$ 5.90
25 Ft.	3/4 in. — Copper / ~~G. I.~~ / ~~C. I.~~	Pipe at 30	$ 7.50
	Nipples ... in. at		$
	Bushings ... to ... in. at		$
	Red'g Inc'g Coupl'gs ... to ... in. at		$
	Union ... in. at		$
	Meter ... in. at		$
	Lead Joints at		$
	Compound Joints at		$
	Hrs. Water Maint. Man—1 at		$
2	Hrs. Water Maint. Man—2 at	1.02	$ 2.04
	Hrs. Labor— ... at		$
	Hrs. Labor— ... at		$
	Hrs. Compressor at		$
	Compensation Ins. at $ ... per C		$ .05
	Trucking		$ 1.00
	Pav't Patch		$
	Tap & Meter		$
			$
			$
	O'head		$
			$ 23.14

This tap is on pipe above 6" Gate on Fremont St
used 115' of 3/4" Copper

155

East

Fremont St. Pl. Ave. No. 44

Name of Owner

Patmor

Labor and Mat'l. Report Oct 16 1948

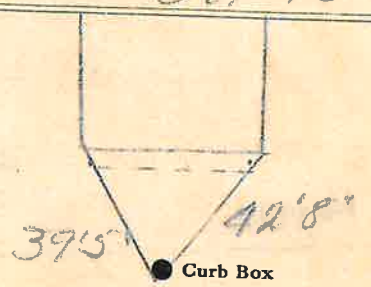

6 Main

Elev. of Main at tap 6

Gate at ●

● Gate at

25' to main

● Curb Box

TAX ID # 309.16-15-8

LSM-SC B 15-48