LABOR AND MATERIALS

_____ Copper / Lead } Connection _____ $ _____

_____ Curb { Cock / Valve / T.S. & V. } _____ in. _____ $ _____

_____ Service box / Old returned { Short 3-1/2 x 4-1/2 / Long 4-1/2 x 5-1/2 } _____ $ _____

14.5' Ft. 3/4 in. { Copper / G.I. / C.I. } Pipe at _____ $ _____

_____ Nipples _____ in. at _____ $ _____

_____ Bushings _____ to _____ in. at _____ $ _____

_____ Red'g

_____ Inc'g

_____ Union _____ in. at _____ $ _____

_____ Meter _____ in. at _____ $ _____

_____ _____ $ _____

_____ Compound Joints at _____ $ _____

_____ Maintenance Foreman _____ $ _____

_____ Hrs. Water Maint. Man - 1 at _____ $ _____

_____ Hrs. Water Maint. Man - 2 at _____ $ _____

_____ Hrs. Garage Foreman _____ at _____ $ _____

_____ Hrs. Labor _____ at _____ $ _____

_____ Hrs. Compressor at _____ $ _____

_____ _____ $ _____

_____ Trucking _____ $ _____

_____ Pav't Patch _____ $ _____

_____ _____ $ _____

_____ _____ $ _____

_____ _____ $ _____

_____ _____ $ _____

$ _____

WEST TREMONT St. Pl. Ave. No. 35 LOT 36

Name of Owner

TAX ID # 309.15-16-36

Labor and Mat'l. Report 19 DEC. 30, 2003

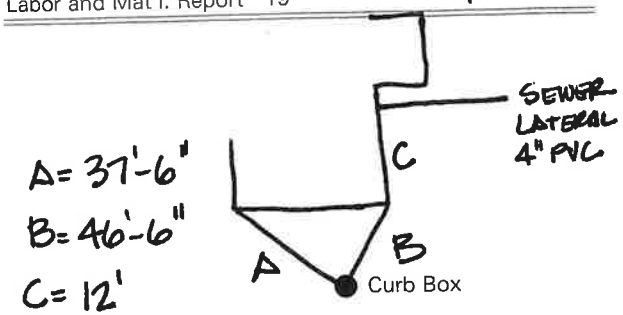

8" Main

Elev. of Main at tap 4.75'

Gate at ●

● Gate at
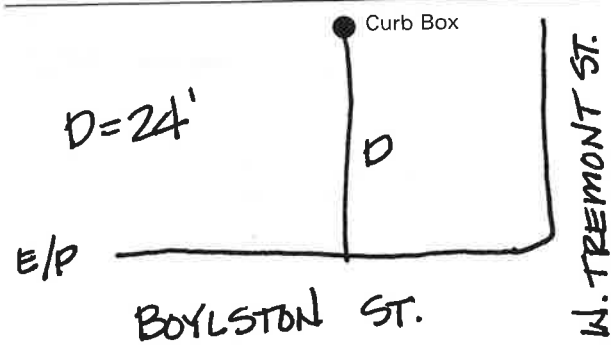
14.5' to main 3/4" copper