LABOR AND MATERIALS

1 Copper ~~Lead~~ Connection 3/4 $

1 Curb Cock ~~Valve~~ ~~T. S. & V.~~ 3/4 in. Oriseal $

1 Service box Old returned ~~Short 3½ x 4½~~ Long 4½ x 5½ ~~Buff or Rdway~~ $

15 Ft. 3/4 in. ~~Copper~~ ~~C. I.~~ ~~C. I.~~ Pipe at $

Nipples in. at $

Bushings to in. at $

Red'g Inc'g Coupl'gs to in. at $

Union in. at $

Meter in. at $

Lead Joints at $

Compound Joints at $

Maintenance Foreman $

Hrs. Water Maint. Man—1 at $

Hrs. Water Maint. Man—2 at $

Hrs. Garage Foreman at $

Hrs. Labor— at $

Hrs. Compressor at $

Compensation Ins. at $ per C $

Trucking $

Pav't Patch $

Tap by Lareau + Co $

8-19-65. $

$

O'head $

$

St. ~~Pl.~~ Ave. No. 39

Uncas

Name of Owner

Marion Frasier

Labor and Mat'l. Report Aug 19 19 65

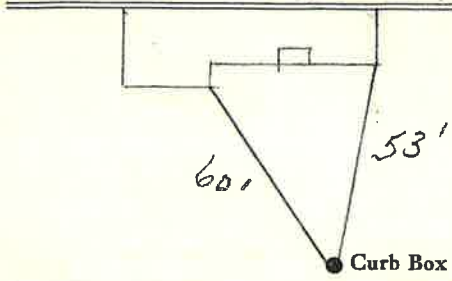

6" C.I. Main

Elev. of Main at tap 5'

Gate at ● ● Gate at

15' to main

3/4" copper ● Curb Box

TAX ID # 303.9-17-1

LSM—5C—3-10-61