LABOR AND MATERIALS

1	Copper ~~Lead~~ Connection	3/4"	$ 2.76
1	Curb Cock ~~Valve~~ T. S. & V.	3/4 in.	$ 3.49
1	Service box Old returned Short 3½X4½ ~~Long 4½X5½~~ ~~Buff or Rdway~~		$ 4.74
24	Ft. 3/4 in. Copper ~~G. I.~~ ~~C. I.~~ Pipe at 38		$ 9.12
	Nipples in. at		$
	Bushings to in. at		$
	Red'g Inc'g Coupl'gs to in. at		$
	Union in. at		$
	Meter in. at		$
	Lead Joints at		$ 18.95
	Compound Joints at		$
	Hrs. Water Maint. Man—1 at		$
4	Hrs. Water Maint. Man—2 at	1.24	$ 4.96
12	Hrs. Labor— at	1.13	$ 13.56
	Hrs. Labor— at		$
2	Hrs. Compressor at	1.50	$ 3.00
	Compensation Ins. at $4.40 per C		$ 2.2
	Trucking		$ 1.00
	Pav't Patch		$ 16.20
Tap by Gibson 5-28-53			$
			$
			$
	O'head		$
			$ 59.65

4345

36-53

St. ~~Pl.~~ 14-16 Ave. No.

Uncas

Name of Owner

Del Signore

Labor and Mat'l. Report May 28 1953

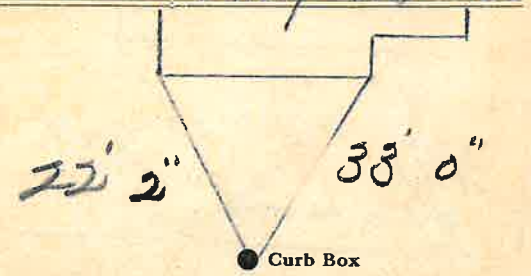

Tap on Oneida St

4" Main

Elev. of Main at tap 4 1/2'

Gate at ● ● Gate at

24' to main

3/4" Copper ● Curb Box

LBM-SC B 15-48