LABOR AND MATERIALS

1 Copper Lead	Connection 3/4	$1.35
1 Curb { Cock / Valve / T. S. & V. }	3/4 in.	$1.88
1 Service Box Old returned { Short 3½x4½ / Long 4½x5½ / Buff. or Rdway }		$1.92
16 Ft. 3/4 in. { Copper / Galv Iron / Cast Iron }	Pipe at 20	$3.20
Nipples ____ in. at		$
Bushings ____ to ____ in. at		$
Red'g / Inc'g	Couplings ____ to ____ in. at	$
Union ____ in. at		$
Meter ____ in. at		$
Lead Joints at		$
Leadite Joints at		$
Hrs. Foreman at		$
7 Hrs. Chauffeur at .55		$3.85
11 Hrs. Tapper at .68¾		$7.56
3 Hrs. Labor at .55		$1.65
Hrs. Labor at		$
4 Hrs. Compressor at .92		$3.68
Compensation Ins.		$ .40
Trucking		$ 1.—
Builders Use of Water Fatch		$5.00
Tap by Hessel		$
		$
		$
		$
		$31.39

H.

5 1942

St. 21
Pl.
Ave. No. 14 Union

Name of Owner

Rounds

Labor and Mat'l. Report Mar 25 19

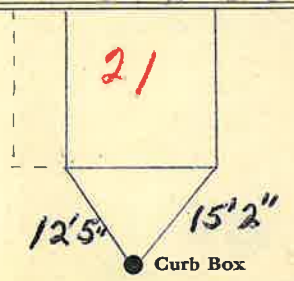

1 Main

Elev. of Main at tap 5—

Gate at ● ● Gate at

¾" Copper 16' to main

● Curb Box

TAX ID# 302.20-12-5