Labor and Materials

1	Copper ~~Lead~~ Connection	3/4	$ 1.46
1	Curb Cock ~~Valve~~ ~~T. S. & V.~~ in	3/4	$ 1.93
1	Service Box Old returned Short 3½ x 4½ ~~Long 4½ x 5½~~ ~~Buff. or Rdway~~		$ 1.77
9	Ft. in. Copper ~~Galv. Iron~~ Cast Iron Pipe at	3/4	$ 1.98
	Nipples in. at		$
	Bushings to in. at		$
	Red'g Inc'g Couplings to in. at		$
	Union in. at		$
	Meter in. at		$
	Lead Joints at		$
	Leadite Joints at		$
	Hrs. Foreman at		$
3	Hrs. Chauffeur at 62½		$ 1.88
	Hrs. Tapper at		$
16	Hrs. Labor at 45		$ 7.20
	Hrs. Labor at		$ 9.08
	Hrs. Compressor at		$
	Compensation Ins.		$ .28
	Trucking		$ 1.00
	Builders Use of Water Patch		$ 5.00
			$
			$
			$
	Tap made by Union		$
			$ 22.50

90-1937

Union St. ~~Pl.~~ Ave. No. 11 26

Name of Owner

Nelson

Labor and Mat'l. Report July 26 1937

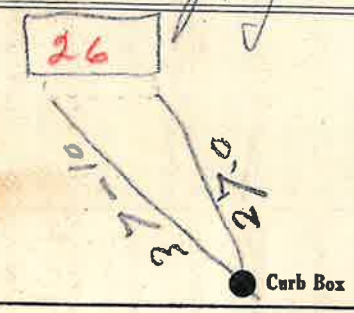

4 Main Gal

Elev. of Main at tap 5

Gate at

Gate at 9' to MAIN

Curb Box

old Tap Shut at Main

This House Razed,

1965