LABOR AND MATERIALS

1	Copper / ~~Lead~~ Connection	3/4"	$ 3.04
1	Curb { ~~Cock~~ / ~~Valve~~ / ~~T. S. & V.~~ }	3/4 in.	$ 3.54
1	Service box { ~~Short 3½x4½~~ / Long 4½x5½ / ~~Buff or Rdway~~ } Old returned		$ 4.70
19	Ft. 3/4 in. { Copper / ~~G. I.~~ / ~~C. I.~~ } Pipe at 35		$ 6.65
	Nipples in. at		$
	Bushings to in. at		$
	Red'g / Inc'g Coupl'gs to in. at		$
	Union in. at		$
	Meter in. at		$
	Lead Joints at		$
	Compound Joints at		$
8	Hrs. Water Maint. Man—1 at		$
	Hrs. Water Maint. Man—2 at 1.13		$ 9.04
16	Hrs. Labor— at 1.02		$ 16.32
	Hrs. Labor— at		$
1	Hrs. Compressor at		$ 1.50
	Compensation Ins. at $ per C.		$ .66
	Trucking		$ 1.00
	Pav't Patch		$ 9.00
			$
			$
			$
	O'head		$
			$ 55.47

Tap by Gifford
8-13-51

St. / ~~Pl.~~ / Ave. No. 9

UNION

Name of Owner

TAX ID # 302.20-12-10

Labor and Mat'l. Report August 14 1951

#9

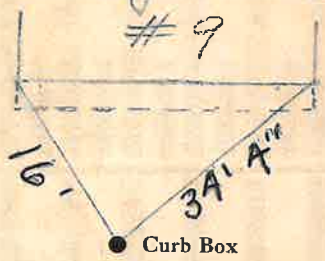

4" Galv. Main

Elev. of Main at tap 6'

Gate at ● ● Gate at

3/4 COPPER 19' to MAIN

● Curb Box

Old Tap disconnected

LSM-5C 10-21-49