Labor and Materials

1 Copper ~~Lead~~ Connection 3/4 ..... $ 3.20

1 Curb { Cock ~~Valve~~ T. S. & V. } ..... in. 3/4 ..... $ 1.00

1 Service Box { Short 3½x4½ ~~Long 4½x65½~~ ~~Buff. or Ridway~~ } Old returned ..... $ 1.30

18 Ft. ..... in. { Copper ~~Galv. Iron~~ ~~Cast Iron~~ } Pipe at 3/4 ..... $ 3.96

..... Nipples ..... in. at ..... $ .....

..... Bushings ..... to ..... in. at ..... $ .....

..... Red'g Inc'g } Couplings ..... to ..... in. at ..... $ .....

..... Union ..... in. at ..... $ .....

..... Meter ..... in. at ..... $ .....

..... Lbs. Br. Stone at ..... $ .....

..... Lbs. Sand at ..... $ .....

..... Bags Cement at ..... $ .....

..... Paving Brick { Mack Red Asphalt } at ..... $ .....

..... Lead Joints at ..... $ .....

..... Leadite Joints at ..... $ 1.88

3 Hrs. Foreman at ..... $ .....

16 Hrs. Common Labor at ..... $ 6.50

..... Hrs. Common Labor at ..... $ .....

..... Hrs Mason at ..... $ .....

..... Hrs Mason's Helper at ..... $ .....

..... Hrs. Compressor at ..... $ .....

..... Compensation Ins ..... $ 1.22

..... Trucking ..... $ 1.00

..... Builders' Use of Water ..... $ .....

Total $ 19.06

28-111 13

Labor and Material Report Aug 31 1928

22 Huron St

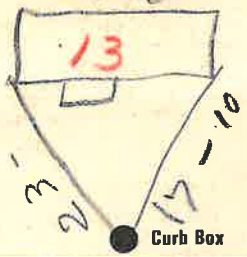

4" Main

Elev of Main at tap 5

Gate at ● 3/4" COPPER 18' to MAIN ● Gate at

● Curb Box

Old Tap 16 12c Shut off

TAX ID # 302.20-12-9