LABOR AND MATERIALS

1	Copper Lead — Connection	3/4	$ 1.59
1	Curb — Clock / Valve / T. S. & V.	3/4 in.	$ 2.74
1	Service box Old returned — Short 3½X4½ / Long 4½X5½ / Buff or Rdway		$ 1.82
19 Ft.	3/4 in. — Copper / Galv. Iron / Cast Iron — Pipe at 19		$ 3.69
	Nipples ... in. at ...		$
	Bushings ... to ... in. at ...		$
	Red'g / Inc'g — Couplings ... to ... in. at ...		$
	Union ... in. at ...		$
	Meter ... in. at ...		$
	Lead Joints at ...		$
	Compound Joints at ...		$
1	Hrs. ~~Foreman at~~ WWM	84	$ .84
5	Hrs. Chauffeur at	75	$ 6.00
5	Hrs. Tapper at	75	$ 3.75
	Hrs. Labor at ...		$
	Hrs. Labor at ...		$
	Hrs. Compressor at ...		$
	Compensation Ins. ...		$ .28
	Trucking ...		$ 1.00
	Builders Use of Water ...	2	$ 5.00
Top by Magnuson			$
			$
			$
			$
			$ 26.71

- Patch

46-45

Union St — St. 17 / Pl. / Ave. No. 18

Name of Owner

Bentley

Labor and Mat'l. Report Nov 27 1945

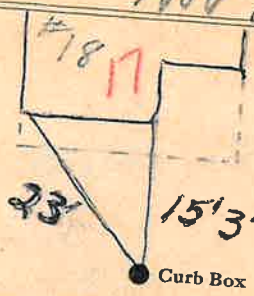

4 Main — Elev. of Main at tap 5½

Gate at ● — ● Gate at

3/4" Copper 19' to main

● Curb Box

TAX ID # 302.20-12-7

LSM-5C-6-1-45