Labor and Materials

1	Copper Lead — Connection	3/4	$ 1.43
1	Curb — Cock ~~Valve~~ ~~T. S. & V.~~	3/4 in 3/4	$ 1.88
1	Service Box ~~Std. pattern~~ — ~~Short 3½ x 4½~~ Long 4½ x 5½ ~~Buff or Rdway~~		$ 1.75
9 Ft. 3/4 in.	~~Galv. Iron~~ ~~Cast Iron~~ Copper	Pipe at 78	$ 1.62
	Nipples in. at		$
	Bushings to in. at		$
	Red'g Inc'g — Couplings to in. at		$
	Union in. at		$
	Meter in. at		$
	Lead Joints at		$
	Leadite Joints at		$
	Hrs. Foreman at		$
3/4	Hrs. Chauffeur at		$ 1.88
3/4	Hrs. Tapper at		$ 2.50
7	Hrs. Labor at		$ 3.15
	Hrs. Labor at		$
	Hrs. Compressor at		$
	Compensation Ins.		$ .23
	Trucking		$ 1.00
	Builders Use of Water — Patch — Tuphy Pavers		$ 5.00
			$
			$
			$
			$ 20.44

1 4 1938

St. 18
Pl:
Union Ave. No. 17½

Name of Owner
Maddan

Labor and Mat'l. Report 4-25-38 19

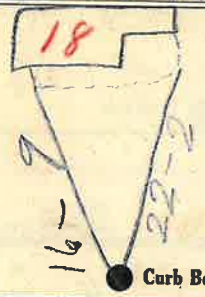

4" galv. Main — Elev. of Main at tap 5

Gate at • Razed 9' to main • Gate at

• Curb Box

This was formerly on the stoke tap. This is a new tap.