LABOR AND MATERIALS

1	Copper ~~Lead~~ } Connection 3/4"	$ 1.80
1	Curb { Cock Valve T. S. & V. } 3/4 in.	$ 1.96
1	Service Box Old returned { Short 3½x4½ Long 4½x5½ Buff or Rdway }	$ 1.82
17	Ft. 3/4 in. { Copper Galv Iron Cast Iron } Pipe at 19	$ 3.23
	Nipples ..... in. at	$
	Bushings ..... to ..... in. at	$
	Red'g Inc'g } Couplings ..... to ..... in. at	$
	Union ..... in. at	$
	Meter ..... in. at	$
	Lead Joints at	$
	Leadite Joints at	$
	Hrs. Foreman at	$
12	Hrs. Chauffeur at	$ 8.25
	Hrs. Tapper at	$
	Hrs. Labor at	$
	Hrs. Labor at	$
	Hrs. Compressor at	$
	Compensation Ins.	$ .22
	Trucking	$ 1.00
	Builders Use of Water	$ 9.36
	Tap by Warsinski	$
		$
		$
		$
		$ 27.64

16/44

Union

St. Pl. Ave. No. 19 ~~16~~

Name of Owner Timmons ~~Bentley~~

Labor and Mat'l. Report July 28 1944

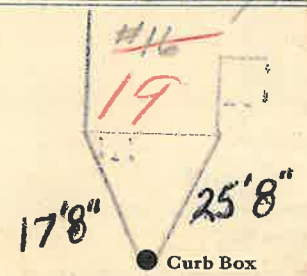

4" galv. Main

Elev. of Main at tap 6

Gate at ● ● Gate at

3/4" Copper 17' to main

● Curb Box

Use Long Wrench

Yellow Tee Wrench

TAX ID# 302.20-12-6