Labor and Materials

1	Copper / ~~Lead~~ Connection 3/4		$ 1.23
1	Curb Cock / Valve / ~~T. S. & V.~~ 3/4 in		$ 1.68
1	Service Box Old returned Short 3½ x 4½ / ~~Long 4½ x 5½~~ / Buff. or Rdway		$ 1.75
23	Ft. 3/4 in. Copper / ~~Galv. Iron~~ / ~~Cast Iron~~ Pipe at 15		$ 3.45
	Nipples in. at		$
1	Bushings 3/4 to 1/2 in. at		$ .04
	Red'g / Inc'g Couplings to in. at		$
	Union in. at		$
	Meter in. at		$
	Lead Joints at		$
	Leadite Joints at		$
	Hrs. Foreman at		$
1½	Hrs. Chauffeur at	62½	$ .94
1½	Hrs. Tapper at	"	$ .94
7½	Hrs. Labor at	45	$ 3.37
	Hrs. Labor at		$
	Hrs. Compressor at		$
	Compensation Ins.		$ .16
	Trucking		$ 1.—
	Builders Use of Water no patch (B.P.)		$
	Taply Warsinski		$
			$
			$
			$
			$ 14.56

9 1 - 1938

25

Vanderbyden St. ~~Pl.~~ ~~Ave.~~ No. 17

Name of Owner

Jas Aust + Sons

Labor and Mat'l. Report 6/20-38 19

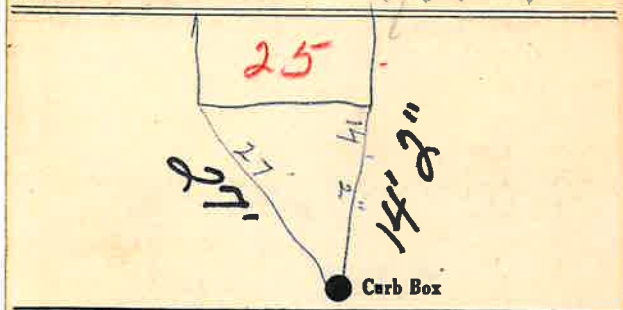

6" Main

Elev. of Main at tap 5

Gate at 3/4" Copper

Gate at 23' to main

Curb Box

TAX ID# 302.16-14-16

Take Billed

old Shelby