Labor and Materials

1	Copper ~~Lead~~ — Connection	3/4	$ 1.23
1	Curb — Cock ~~Valve~~ ~~T. S. & V.~~	3/4 in	$ 1.68
1	Service Box Old returned — ~~Short 3½ x 4½~~ Long 4½ x 5½ ~~Buff. or Rdway~~		$ 1.75
9	Ft. 3/4 in. — Copper ~~Galv Iron~~ ~~Cast Iron~~ Pipe at		$ 1.35
	Nipples in. at		$
1	Bushings 1/4 to 1 in. at		$ .03
	Red'g Inc'g — Couplings 2 to in. at		$
	Union in. at		$
	Meter in. at		$
	Lead Joints at		$
	Leadite Joints at		$
	Hrs. Foreman at		$
1 1/2	Hrs. Chauffeur at 62 1/2		$ 94
1 1/2	Hrs. Tapper at		$ 94
7 1/2	Hrs. Labor at 45		$ 3.37
	Hrs. Labor at		$
	Hrs. Compressor at		$
	Compensation Ins.		$ 16
	Trucking		$ 1.00
	Builders Use of Water (no Paid) (BP)		$
	Tapby Waisunski		$
			$
			$
			$ 12.45

8 8 - 1938

Londerhole St. ~~Pl.~~ ~~Ave.~~ No. 26 12

Name of Owner

Fred Hall

Labor and Mat'l. Report 6-20-38 19

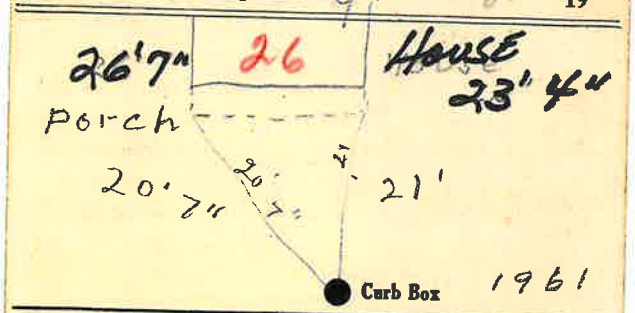

6" Main — Elev. of Main at tap 4'

Gate at • 3/4" COPPER 9' to MAIN • Gate at

● Curb Box

TAX ID# 302.16-13-2

to be Billed old Shut off