Labor and Materials

1	Copper / ~~Lead~~ Connection	3/4	$ 1.23
1	Curb Cock / Valve / T. S. & V.	3/4 in	$ 1.68
1	Service Box Old returned — Short 3½ x 4½ / Long 4½ x 5½ / Buff. or Rdway		$ 1.75
9 Ft.	3/4 in. — ~~Copper~~ / ~~Galv. Iron~~ / Cast Iron Pipe at		$ 1.35
	Nipples in. at		$
1	Bushings 3/4 to 1 in. at		$ .04
	Red'g Inc'g Couplings to in. at		$
	Union in. at		$
	Meter in. at		$
	Lead Joints at		$
	Leadite Joints at		$
11½	Hrs. Foreman at 62½		$ .94
11½	Hrs. Chauffeur at		$ .94
7½	Hrs. Tapper at		$ 3.38
7½	Hrs. Labor at 45		$
	Hrs. Labor at		$
	Hrs. Compressor at		$ .16
	Compensation Ins.		$ 1.—
	Trucking		$
	Builders Use of Water		$
	Tapped Hassell		$
			$
			$
			$ 12.47

8 9 - 1938

St. 28
Pl.
Ave. No. 14

Name of Owner

Brooks

Labor and Mat'l. Report June 21 19

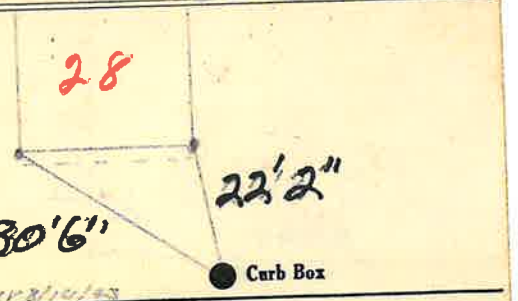

Neyer Valves

6 Main

Elev. of Main at tap 4½

Gate at ● ● Gate at

¾" Copper 9' to main

● Curb Box

TAX ID # 302.16-13-4

1/2 to be billed old shut off