Labor and Materials

1	Copper ~~Lead~~ Connection 3/4	$ 1.23
1	Curb Cock / ~~Valve~~ / ~~T. S. & V.~~ 3/4 in	$ 1.68
1	Service Box Old returned — Short 3½ x 4½ / Long 4½ x 5½ / Buff. or Rdway	$ 1.75
8	Ft. 3/4 in. Copper / ~~Galv. Iron~~ / ~~Cast Iron~~ Pipe at 15	$ 1.20
	Nipples in. at	$
1	Bushings 3/4 to 1/2 in. at	$ .04
	Red'g / Inc'g Couplings to in. at	$
	Union in. at	$
	Meter in. at	$
	Lead Joints at	$
	Leadite Joints at	$
	Hrs. Foreman at	$
1½	Hrs. Chauffeur at 6½	$ .94
1½	Hrs. Tapper at 7	$ .94
7½	Hrs. Labor at 45	$ 3.37
	Hrs. Labor at	$
	Hrs. Compressor at	$
	Compensation Ins.	$ .16
	Trucking	$ 1.—
	Builders Use of Water Hopatch (B.P.)	$
	Tap by Hessell	$
		$
		$
		$
		$ 12.31

9 3 - 1938

St. ~~Pl.~~ Ave. No. 20 34

Vanderhuden

Name of Owner

Crokley

Labor and Mat'l. Report June 21 19~~38~~

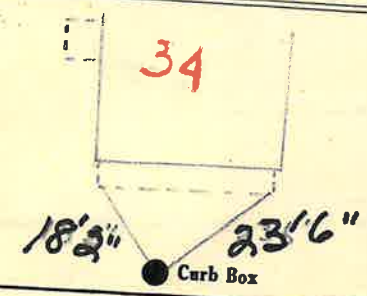

6 Main — Elev. of Main at tap 4

Gate at • — • Gate at

3/4 copper — 8' to MAIN

● Curb Box

TAX ID# 302.16-13-7

To Be Billed old shut off