Labor and Materials

1	Copper / ~~Lead~~	Connection 3/4	$ 1.23
1	Curb	Cock / ~~Valve~~ / ~~T. S. & V.~~ 3/4 in	$ 1.68
1	Service Box / Old returned	Short 3½ x 4½ / ~~Long 4½ x 5½~~ / Buff. or Rdway	$ 1.75
9	Ft. 3/4 in.	Copper / ~~Galv. Iron~~ / Cast Iron Pipe at	$ 1.35
	Nipples	in. at	$
1	Bushings	3/4 to 1/2 in. at	$ .03
	Red'g / Inc'g	Couplings to in. at	$
	Union	in. at	$
	Meter	in. at	$
	Lead Joints at		$
	Leadite Joints at		$
	Hrs. Foreman at		$
3	Hrs. Chauffeur at	62½	$ 1.88
2	Hrs. Tapper at	–	$ 1.25
8	Hrs. Labor at	45	$ 3.60
	Hrs. Labor at		$
	Hrs. Compressor at		$
	Compensation Ins.		$ .21
	Trucking		$ 1.–
	Builders Use of Water	no patch (BSP)	$
	Typing Warsinski		$
			$
			$
			$
			$ 13.98

8 3 - 1938

St. / Pl. / Ave. No. 8 2

Name of Owner: Farrel

Labor and Mat'l. Report 6/16-38 19

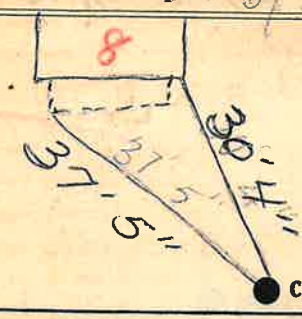

6" Main — Elev. of Main at tap 4'

Gate at 3/4" copper — Gate at 9' to MAIN

Curb Box

TAX ID# 302.16-15-1

16 bu Bulled old Shoot