Labor and Materials

-1	Copper / ~~Lead~~ Connection	3/4	$ 1.23
1	Curb { Cock / ~~Valve~~ / ~~T. S. & V.~~ }	3/4 in	$ 1.68
1	Service Box Old returned { ~~Short 3½ x 4½~~ / Long 4½ x 5½ / Buff. ~~or~~ Rdway }		$ 1.75
93	Ft. 3/4 in. { Copper / ~~Galv Iron~~ / ~~Cast Iron~~ } Pipe at	15	$ 3.45
	Nipples in. at		$
	Bushings to in. at		$
	Red'g / Inc'g Couplings to in. at		$
	Union in. at		$
	Meter in. at		$
	Lead Joints at		$
	Leadite Joints at		$
	Hrs. Foreman at		$
1½	Hrs. Chauffeur at	62½	$ 94
1½	Hrs. Tapper at		$ 94
7½	Hrs. Labor at	45	$ 3.37
	Hrs. Labor at		$
	Hrs. Compressor at		$
	Compensation Ins.		$ 16
	Trucking		$ 1.—
	Builders Use of Water Napatech (13.P)		$
	Tap by Miller		$
			$
			$
			$
			$ 14.52

8 5 - 1938

St. 9
Pl. ~~Pl.~~
Ave. Vanderbilt No. 5

Name of Owner TAX ID
Linehan #302.16-16-10

Labor and Mat'l. Report June 16 193~~5~~

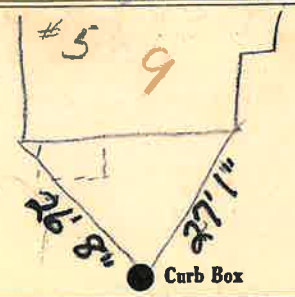

6 Main

Elev. of Main at tap 4½

Gate at • • Gate at
3/4" Copper 23' to main

● Curb Box

To be tested Thursday