Labor and Materials

1	Copper / ~~Lead~~ Connection	3/4	$ 1.23
1	Curb Cock / ~~Valve~~ / T. S. & V.	3/4 in	$ 1.68
1	Service Box Old returned Short 3½ x 4½ / ~~Long 4½ x 5½~~ / Buff. or Rdway		$ 1.75
9	Ft. 3/4 in. Copper / ~~Galv Iron~~ / ~~Cast Iron~~ Pipe at		$ 1.35
	Nipples in. at		$
1	Bushings 3/4 to 1/2 in. at		$ .04
	Red'g / Inc'g Couplings to in. at		$
	Union in. at		$
	Meter in. at		$
	Lead Joints at		$
	Leadite Joints at		$
	Hrs. Foreman at		$
1½	Hrs. Chauffeur at	62½	$ 94
1½	Hrs. Tapper at	7	$ 94
7½	Hrs. Labor at	45	$ 3.38
	Hrs. Labor at		$
	Hrs. Compressor at		$
	Compensation Ins.		$ .16
	Trucking		$ 1.—
	Builders Use of Water	no patch (B.P.)	$
	Tuphy Warsinski		$
			$
			$
			$
			$ 12.47

8 4 - 1938

St. 10
Pl.
Ave. No. 4

Wonderhyde

Name of Owner

Foley

Labor and Mat'l. Report 6/16-38 19

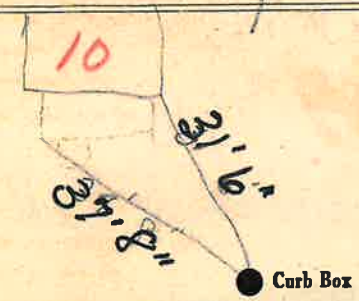

6" Main

Elev. of Main at tap 4'

Gate at • 3/4" copper 9' to main • Gate at

Curb Box

TAX ID # 302.16-15-2

Robo Build old shed [illegible]