Labor and Materials

1	Copper ~~Lead~~ Connection 3/4	$ 1.23
1	Curb { Cock ~~Valve~~ T. S. & V. } 3/4 in	$ 1.68
1	Service Box Old returned { Short ~~3½ x 4½~~ Long 4½ x 5½ ~~Buff. or Ruby~~ }	$ 1.75
23 Ft. 3/4 in.	{ Copper ~~Galv. Iron~~ ~~Cast Iron~~ } Pipe at	$ 3.45
	Nipples in. at	$
	Bushings to in. at	$
	Red'g Inc'g { Couplings to in. at	$
	Union in. at	$
	Meter in. at	$
	Lead Joints at	$
	Leadite Joints at	$
	Hrs. Foreman at	$
1¼	Hrs. Chauffeur at	$ 94
1¼	Hrs. Tapper at	$ 94
7¼	Hrs. Labor at	$ 3.38
	Hrs. Labor at	$
	Hrs. Compressor at	$
	Compensation Ins.	$ 16
	Trucking	$ 1.-
	Builders Use of Water inspect (A.P.)	$
Tap by Miller		$
		$
		$
		$ 14.53

8 7 - 1938

St. Pl. Ave. Vanderbilt No. 11

Name of Owner

Brown - Frances

Labor and Mat'l. Report June 1938

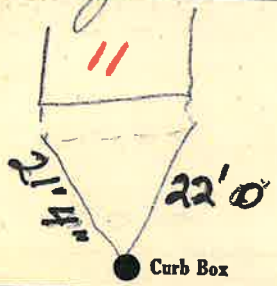

6 Main

Elev. of Main at tap 4'

Gate at • • Gate at

• Curb Box

23' to main

TAX FD# 302.16-16-9

To be Billed old Shut off 4/8