Labor and Materials

1	~~Lead~~ Connection 3/4	$
1	Curb Cock 3/4	$
1	Service Box { ~~Short 3½ x 4½~~ / Long 4½ x 5½ / Buffalo } Old returned	$
8	Ft. ... in. ~~G. I.~~ Pipe at cost	$
	Nipples ... in. at	$
	Bushings ... to ... in. at	$
	Red'g Coup ... to ... in. at	$
	Inc'g Coup ... to ... in. at	$
	Union ... in. at	$
	Meter ... in. at	$
	Cu. Yds. Br. Stone at	$
	Cu. Yds. Sand at	$
	Bags Cement at	$
	Paving Brick { Mack / Red / Asphalt } at	$
2	Hrs. Foreman at	$
12	Hrs. Common Labor at	$
	Hrs. Mason at	$
	Hrs. at	$
	Hrs. at	$
945	Builders' Use of Water	$
	at	$
TRUCK LOAD	at	$
	at	$
	at	$
	Total	$ 1333

Labor and Material Report Sept 4 1915

73 WAITST

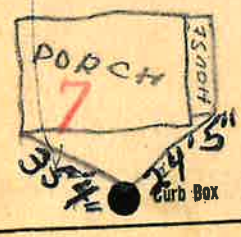

6" Main

Elev. of Main at tap 5'

Gate at ● 8' to MAIN ● Gate at

● Curb Box

TAX ID # 302.20-13-12