Labor and Materials

1	Lead Connection 3/4	$
1	Curb Cock 3/4	$
1	Service Box {Short 3½ x 4½ / ~~Long 4½ x 6½~~ / ~~Buffalo~~}	$
8	Ft. in. G. I. Pipe at	$
	Nipples in. at	$
1	Bushings ~~1~~ 1/2 to ~~1~~ 3/4 in. at	$
	Red'g Coup to in. at	$
	Inc'g Coup to in. at	$
	Union in. at	$
	Meter in. at	$
	Cu. Yds. Br. Stone at	$
	Cu. Yds. Sand at	$
	Bags Cement at	$
	Paving Brick {Mack / Red / Asphalt} at	$
2	Hrs. Foreman at	$
12	Hrs. Common Labor at	$
	Hrs. Mason at	$
	Hrs. at	$
	Hrs. at	$
Qty	Builders' Use of Water	$
	at	$
	Truck 100 at	$
	at	$
	at	$
	Total	$ 14.63

Labor and Material Report Feb 3 19 24

95 WAIT ST

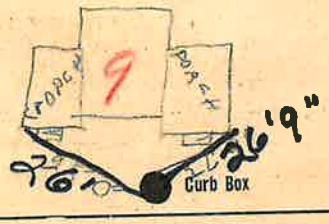

6 Main — Elev. of Main at tap 5

Gate at ● — ● Gate at

8' to MAIN

TAX ID # 302.20-13-11