LABOR AND MATERIALS

1 Copper / ~~Lead~~ } Connection 3/4" $

1 Curb { Cock / ~~Valve~~ / T. S. & V. } 3/4" in. $

1 Service box / Old returned { Short 3½ x 4½ / Long 4½ x 5½ / ~~Buff or Rdway~~ } $

13 Ft. 3/4 in. { Copper / ~~Cr I.~~ / ~~Cr I.~~ } Pipe at $

Nipples in. at $

Bushings to in. at $

Red'g / Inc'g Coupl'gs to in. at $

Union in. at $

Meter in. at $

Lead Joints at $

Compound Joints at $

Maintenance Foreman $

Hrs. Water Maint. Man—1 at $

Hrs. Water Maint. Man—2 at $

Hrs. Garage Foreman at $

Hrs. Labor— at $

Hrs. Compressor at $

Compensation Ins. at $ per C $

Trucking $

Pav't Patch $

$

Tap April 26, 1977 $

$

O'head $

$

St. Pl. Ave. No. Wallace Dr. 6

Name of Owner

Veron D. Gooch

Labor and Mat'l. Report April 26 1977

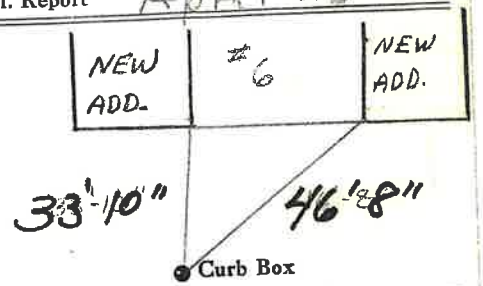

6" Main

Elev. of Main at tap 5'

Gate at

Gate at

3/4" copper 13' to main

Curb Box

TAX ID# 303.9-17-3

LSM—5C—6-1-67