LABOR AND MATERIALS

1	Copper Lead — Connection	3/4	$2.94
1	Curb — Cock / Valve / T. S. & V.	3/4 in.	$3.71
1	Service box — Old returned — Short 3½X4½ / Long 4½X5½ / Buff or Rdway		$5.90
4'9"	Ft. 3/4 in. — Copper / G. I. / C. I. — Pipe at 30		$2.40
	Nipples ..... in. at		$
	Bushings ..... to ..... in. at		$
	Red'g Inc'g — Coupl'gs ..... to ..... in. at		$
	Union ..... in. at		$
	Meter ..... in. at		$
	Lead Joints at		$
	Compound Joints at		$
3	Hrs. Water Maint. Man—1 at 1.01		$3.03
3	Hrs. Water Maint. Man—2 at .91		$2.73
11	Hrs. Labor— ....at 80		$8.80
	Hrs. Labor— ....at		$
	Hrs. Compressor at		$
	Compensation Ins. at $ ..... per C		$.32
	Trucking	1	
	Pav't Patch — Before Paving		$
	Tap by Miller		$
			$
			$
	O'head		$
			$30.83

COPPER SHORTENED
7-21-2003
KH

112

St. Walnut Pl. Ave. No. 25

Name of Owner

Jas Riggsdale

Labor and Mat'l. Report June 8 19 48

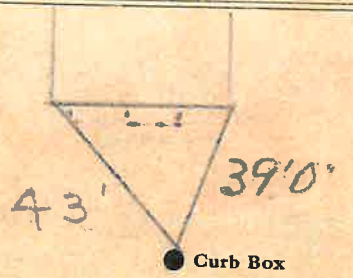

1 Main — Elev. of Main at tap 4

Gate at ● — ● Gate at

¾ Copper — 4'9" to main

● Curb Box

TAX ID # 303.17-12-10

LSM-SC 5 19-48 Tobe Billard