LABOR AND MATERIALS

1	Copper / ~~Lead~~ Connection	3/4	$ 1.79
1	Curb { Clock / Valve / T. S. & V. }	3/4 in.	$ 2.61
1	Service box / Old returned { Short 3½X4½ / Long 4½X5½ / Buff or Rdway }		$ 1.82
4'9" 10-15-2003 ~~10~~	Ft. 3/4 in. KH { Copper / ~~Galv. Iron~~ / ~~Cast Iron~~ } Pipe at 23		$ 2.30
1	Nipples 3/4 in. at 3" long		$ 20
1	Bushings 3/4 to 1 in. at		$ 05
1	~~Red'g~~ / ~~Inc'g~~ Couplings 1" to — in. at		$ 18
	Union in. at		$
	Meter in. at		$
	Lead Joints at		$
	Compound Joints at		$
	Hrs. Foreman at		$
	Hrs. Chauffeur at		$
4	Hrs. Tapper at	82½	$ 3.30
10	Hrs. Labor at	71½	$ 7.15 10.45
	Hrs. Labor at		$
	Hrs. Compressor at		$
	Compensation Ins.		$ 29
	Trucking		$ 1.—
	Builders Use of Water		$ 5.—
	Taply Magnum		$
			$
			$
			$
			$ 25.69

Walnut

St. ~~Pl.~~ Ave. No. ~~41~~ 39

Name of Owner

Scialdone

Labor and Mat'l. Report Oct 30 1946

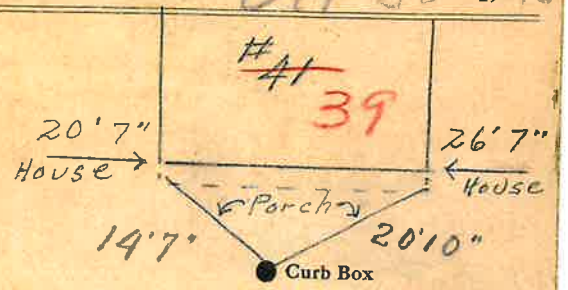

4 Main

Elev. of Main at tap 6"

Gate at ● ● Gate at

3/4" Copper 4'9" to main

● Curb Box

Tax ID # 303.17-3-8

LSM-5C-6-1-45