LABOR AND MATERIALS

1	Copper / ~~Lead~~ } Connection 3/4	$ 1.80
1	Curb { Cock / ~~Valve~~ / T. S. & V. } 3/4 in.	$ 1.96
1	Service Box Old returned 26' 4" 10/10/03 KH { Short 3½x4½ / ~~Long 4½x5½~~ / ~~Buff or Rdway~~ }	$ 1.82
~~21~~	Ft. 3/4 in. { Copper / ~~Galv Iron~~ / ~~Cast Iron~~ } Pipe at 19	$ 4.01
	Nipples ... in. at	$
	Bushings ... to ... in. at	$
	Red'g / Inc'g } Couplings ... to ... in. at	$
	Union ... in. at	$
	Meter ... in. at	$
	Lead Joints at	$
	Leadite Joints at	$
	Hrs. Foreman at	$
12	Hrs. Chauffeur at 68¾	$ 8.25
	Hrs. Tapper at	$
	Hrs. Labor at	$
	Hrs. Labor at	$
1	Hrs. Compressor at 87½	$ .88
	Compensation Ins.	$ .22
	Trucking	$ 1.00
	Builders Use of Water	$ 5.~~85~~
	Tap by Watsinski	$
		$
		$
		$
		$ 25.79

32744

St. / ~~Pl.~~ / ~~Ave.~~ No. 42

Walnut

Name of Owner

Bisignano

Labor and Mat'l. Report Oct 25 1944

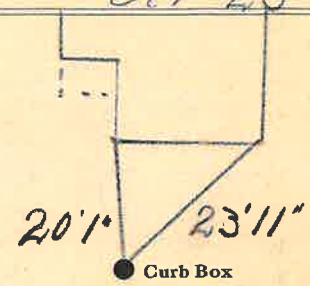

4 Main

Elev. of Main at tap 5

Gate at ● 3/4" Copper

● Gate at 26' 4" to main

● Curb Box

Tax ID # 303.17-2-4