LABOR AND MATERIALS

1	Copper / ~~Lead~~	Connection 3/4	$ 2.94
1	Curb	Cock / ~~Valve~~ / ~~T. S. & V.~~ 3/4 in.	$ 3.71
1	Service box	Short 3½X4½ / Long 4½X5½ / Buff or Rdway	
	Old returned 5'5" 10/17/03 1¼		$ 5.90
~~1~~	Ft. 3/4 in.	Copper / C. I. / ~~C. I.~~ Pipe at 30	$ 3.00
	Nipples in. at		$
	Bushings to in. at		$
	Red'g Inc'g Coupl'gs to in. at		$
	Union in. at		$
	Meter in. at		$
	Lead Joints at		$
	Compound Joints at		$
	Hrs. Water Maint. Man—1 at		$
7	Hrs. Water Maint. Man—2 at 10.7		$ 7.14
13	Hrs. Labor— at 91		$ 11.83
	Hrs. Labor— at		$
	Hrs. Compressor at		$
	Compensation Ins. at $ per C		$ .42
	Trucking		$ 1.—
	Pav't Patch Before Paving		$ —.7
	Tap by Mathews		$
			$
			$
	O'head		$
			$ 35.94

137

St. / ~~Pl.~~ Walnut Ave. No. 51

Name of Owner

Glens Falls Coal Co.

Labor and Mat'l. Report Sept 22 19 45

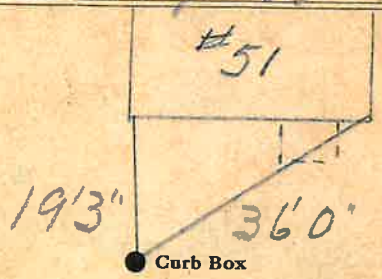

1 Main Elev. of Main at tap 3—

Gate at ● ● Gate at

3/4 copper 5'5" to main

● Curb Box

LSM-SC 5 15-48 To be Billed