LABOR AND MATERIALS

1	Copper / ~~Lead~~ Connection	3/4	$ 2.94
1	Curb { Cock / Valve / T. S. & V. }	3/4 in.	$ 3.71
1	Service box { Short 3½X4½ / ~~Long 4½X5½~~ / Old returned / Buff or Rdway }		$ 5.90
~~23~~ 28'5"	Ft. 3/4 in. { Copper / ~~G. I.~~ / ~~C. I.~~ } Pipe at 30		$ 6.90
	Nipples ... in. at		$
	Bushings ... to ... in. at		$
	Red'g Inc'g Coupl'gs ... to ... in. at		$
	Union ... in. at		$
	Meter ... in. at		$
	Lead Joints at		$
	Compound Joints at		$
	Hrs. Water Maint. Man—1 at		$
7	Hrs. Water Maint. Man—2 at	1.02	$ 7.14
12	Hrs. Labor— ... at	91	$ 10.92 18.06
	Hrs. Labor— ... at		$
	Hrs. Compressor at		$
	Compensation Ins. at $ ... per C		$ .40
	Trucking		$ 1.00
	Pav't Patch Before Paving		$ —
Tap & Meter Install			$
			$
			$
	O'head		$
			$ 38.91

138

St. / ~~Pl.~~ / ~~Ave.~~ No. 52

Walnut

Name of Owner

Paul Currier

Labor and Mat'l. Report Sept 21 1948

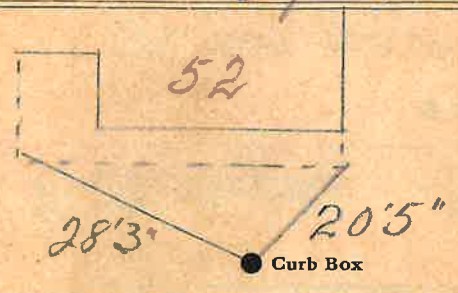

4 Main

Elev. of Main at tap 5

Gate at ● 3/4 Copper

● Gate at 28'5" to MAIN

● Curb Box

RENEWAL TAP — 1989

TAX ID # 303.17-2-9

LSM-5C 8 15-48 Tobe Billed