LABOR AND MATERIALS

1 Copper ~~Lead~~ } Connection 3/4 $ 1.79

1 Curb { Cock / Valve / T. S. & V. } 3/4 in. $ 2.61

1 Service Box ~~Old returned~~ { Short 3½x4½ / Long 4½x5½ / Buff. or Rdway } Same $ —

27 FT 5 INCHES

~~26~~ Ft. 3/4 in. { Copper / ~~Galv Iron~~ / ~~Cast Iron~~ } Pipe at 23 $ 6.44

Nipples ____ in. at ____ $

Bushings ____ to ____ in. at ____ $

Red'g / Inc'g } Couplings ____ to ____ in. at ____ $

Union ____ in. at ____ $

Meter ____ in. at ____ $

Lead Joints at ____ $

Leadite Joints at ____ $

Hrs. Foreman at ____ $

10 Hrs. Chauffeur at 82½ $ 8.25

Hrs. Tapper at ____ $

26 Hrs. Labor at 71½ $ 18.59

Hrs. Labor at ____ $

2 Hrs. Compressor at 87½ $ 1.75

Compensation Ins. ____ $ .74

Trucking ____ $ 1.

Builders Use of Water ____ $ 5.00

tap by Warsinski ____ $

$ 46.17

St.
~~Pl.~~
~~Ave.~~ No. 66

Walnut

Name of Owner

Donuhue

Labor and Mat'l. Report Sept 20 1946

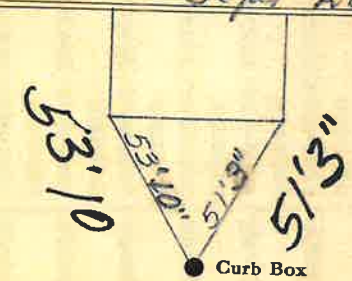

4 Main

Elev. of Main at tap 5

Gate at ● ● Gate at

3/4" Copper 27'5" to main

● Curb Box

TAX ID # 303.13-17-5