LABOR AND MATERIALS

1	Copper / Lead } Connection 3/4	$ 1.78
1	Curb { Clock Valve / T. S. & V. } 3/4 in.	$ 2.61
	Service box / Old returned { Short 3½X4½ / Long 4½X5½ / Buff or Rdway } Same Box	$
6 FT	KK 11-19-03	
~~14~~	Ft. 3/4 in. { Copper / Galv. Iron / Cast Iron } Pipe at 23	$ 3.22
	Nipples in. at	$
	Bushings to in. at	$
	Red'g / Inc'g } Couplings to in. at	$
	Union in. at	$
	Meter in. at	$
	Lead Joints at	$
	Compound Joints at	$
	Hrs. Foreman at	$
	Hrs. Chauffeur at	$
6	Hrs. Tapper at 82½	$ 4.95
	Hrs. Labor at	$
11	Hrs. Labor at 71½	$ 7.87
2	Hrs. Compressor at 87½	$ 1.75
	Compensation Ins.	$ .35
	Trucking	$ 1.00
	Builders Use of Water. 2	$ 5.00
	Tap by Mogollon	$
		$
		$
		$
		$ 28.53

✓

101-46

Walnut St. ~~Pl.~~ ~~Ave.~~ No. 67

Name of Owner

Collins

Labor and Mat'l. Report Oct 31 1946

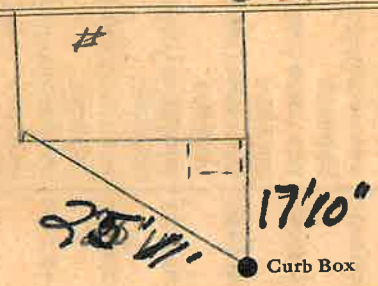

4" Main

Elev. of Main at tap 7

Gate at ●

● Gate at

6' to main

● Curb Box

TAX ID # 303.13-18-3

LSM-5C-6-1-45