LABOR AND MATERIALS

1	Copper ~~Lead~~ Connection 3/4		$ 1.79
1	Curb {Clock ~~Valve~~ ~~T. S. &~~ V.} 3/4 in.		$ 2.61
1	Service box Old returned {~~Short 3½X4½~~ Long 4½X5½ ~~Buff or Rdway~~} 29'6"		$ 1.82
~~20~~	Ft. 3/4 in. {Copper ~~Galv. Iron~~ ~~Cast Iron~~} Pipe at 73		$ 5.06
	Nipples in. at		$
	Bushings to in. at		$
	Red'g Inc'g Couplings to in. at		$
	Union in. at		$
	Meter in. at		$
	Lead Joints at		$
	Compound Joints at		$
4	Hrs. ~~Foreman~~ at WWM	.84	$ 3.36
18	Hrs. Chauffeur at	.75	$ 13.50
3	Hrs. Tapper at	.75	$ 2.25
16	Hrs. Labor at	.65	$ 12.00
	Hrs. Labor at		$
2	Hrs. Compressor at	.87½	$ 1.75
	Compensation Ins.		$ .86
	Trucking		$ 1.00
	Builders Use of Water		$ 5.00
	Taply Warsinski		$
			$
			$
			$
			$ 51.00

✓

---

4 ✓ 46

Walnut St. ~~Pl.~~ ~~Ave.~~ No. 72

Name of Owner

Donohue

Labor and Mat'l. Report Jan 2 1945

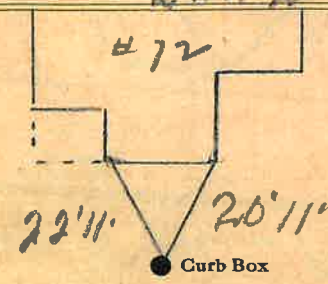

6 Main Elev. of Main at tap 6

Gate at ● ● Gate at

3/4" COPPER 29'6" to MAIN

● Curb Box

TAX ID# 303.13-17-8

LSM-5C-6-1-45 This Tap to be Billed ✓