LABOR AND MATERIALS

1	Copper ~~Lead~~ Connection 3/4	$ 1.31
1	Curb {Cock / Valve / T. S. & V.} 3/4 in.	$ 1.75
1	Service Box ~~Old returned~~ {Short 3½x4½ / Long 4½x5½ / Buff. or Rdway}	$ 1.60
9	Ft. 3/4 in. {Copper / ~~Galv Iron~~ / ~~Cast Iron~~} Pipe at 18	$ 1.62
	Nipples ____ in. at	$
	Bushings ____ to ____ in. at	$
	Red'g / Inc'g Couplings ____ to ____ in. at	$
	Union ____ in. at	$
	Meter ____ in. at	$
	Lead Joints at	$
	Leadite Joints at	$
	Hrs. Foreman at	$
6	Hrs. Chauffeur at 62½	$ 3.75
6	Hrs. Tapper at "	$ 3.75
10	Hrs. Labor at 45	$ 4.50
	Hrs. Labor at	$
	Hrs. Compressor at	$
	Compensation Ins.	$ .37
	Trucking	$ 1.—
	Builders Use of Water Patch	$ 5.00
	Tap by Hessel	$
		$
		$
		$
		$ 24.65

1940

St.
Pl.
Walnut St Ave. No. 17

Name of Owner

Behren

Labor and Mat'l. Report May 17 1940

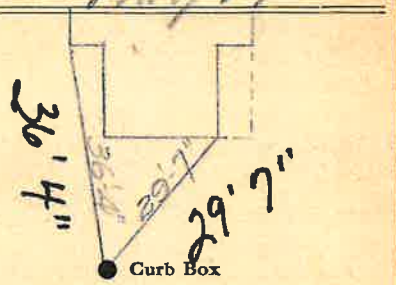

4 Main

Elev. of Main at tap 6

Gate at ● ● Gate at

3/4" copper 9' to main

● Curb Box

TAX ID# 303.17-12-14

O/C Shut off