Labor and Materials

1	Copper / ~~Lead~~ Connection	$3.20
1	Curb { Cock / ~~Valve~~ / ~~T. S. & V.~~ } ..... in.	$1.50
1	Service Box / ~~Old returned~~ { ~~Short 3½ x 4½~~ / Long 4½ x 5½ / ~~Buff. or Rdway~~ }	$1.40
32	Ft. ¾ in. { Copper / ~~Galv. Iron~~ / ~~Cast Iron~~ } Pipe at	$7.04
	Nipples ..... in. at	$
	Bushings ..... to ..... in. at	$
1	Red'g / Inc'g Couplings ¾ to ..... in. at	$ .15
	Union ..... in. at	$
	Meter ..... in. at	$
	Lbs Br. Stone at	$
	Lbs. Sand at	$
	Bags Cement at	$
	Paving Brick { Mack / Red / Asphalt } at	$
	Lead Joints at	$
	Leadite Joints at	$
8	Hrs. Foreman at	$ 5.50
36	Hrs. Common Labor at	$ 13.80
	Hrs. Common Labor at	$
	Hrs. Mason at	$
	Hrs Mason's Helper at	$
1½	Hrs. Compressor at	$ 2.25
	Compensation Ins.	$ .50
	Trucking	$ 1.50
	Builders' Use of Water	$
	Payment	
	Total	$ 35.34

Labor and Material Report Nov 19 19 25

175 - 177 Warren St

275

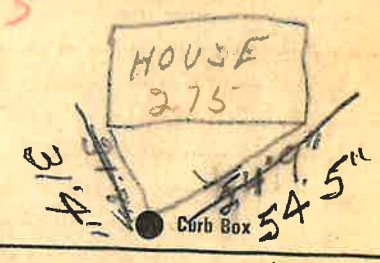

TAX ID# 310.6-1-14

Main

Elev. of Main at tap

Gate at

Gate at

3/4" copper

32' to main

Curb Box

House To be Razed
Shut off At Curb
4-4-1975