LABOR AND MATERIALS

1 Copper / ~~Lead~~ Connection 2" $

1 Curb { Cock / ~~Valve~~ / ~~T. S. & V.~~ } 2 in. $

1 Service box { ~~Short 3½ x 4½~~ / ~~Long 4½ x 5½~~ / ~~Buff or Rdway~~ } Old returned $

13 Ft. 2 in. { Copper / ~~G. I.~~ / ~~C. I.~~ } Small. Pipe at $

Nipples in. at $

Bushings to in. at $

Red'g / Inc'g Coupl'gs to in. at $

Tony Shut off

Hrs. Compressor at $

Compensation Ins. at $ per C $

Trucking $

Pav't Patch $

Tap by Giessard & Co. 8-3 to 5-55 $

$

O'head $

$

4'-7" - 2" Brass Pipe.

St. / ~~Pl.~~ Warren Ave. No. 73

Name of Owner

U.S. Post Office.

Labor and Mat'l. Report Aug 3-5 1955.

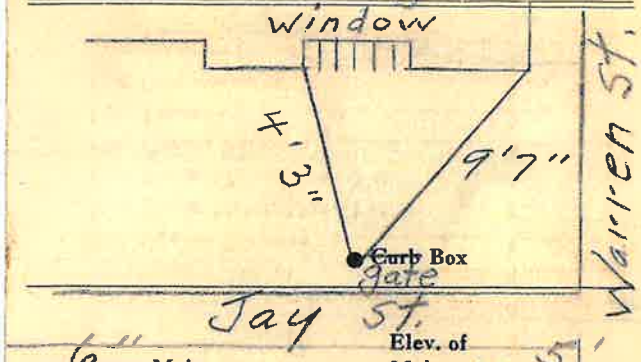

6" Main Elev. of Main at tap 5'

Gate at • • Gate at

2" copper 13' to main

#67-73 • Curb Box

TAX LOT 310-5-2-3

LSM—6C—2-5 56