Labor and Materials

.....Lead Connection ..... $.....

.....Curb Cock ..... $.....

.....Service Box / Old returned { Short 3½ x 4½ / Long 4½ x 6½ / Buffalo } $.....

.....Ft. .....in. G. I. Pipe at ..... $.....

.....Nipples .....in. at ..... $.....

.....Bushings .....to.....in. at ..... $.....

.....Red'g Coup....to....in. at ..... $.....

.....Inc'g Coup....to....in. at ..... $.....

.....Union....in. at ..... $.....

.....Meter....in. at ..... $.....

.....Cu. Yds. Br. Stone at ..... $.....

.....Cu. Yds. Sand at ..... $.....

.....Bags Cement at ..... $.....

.....Paving Brick { Mack / Red / Asphalt } at ..... $.....

.....Hrs. Foreman at ..... $.....

.....Hrs. Common Labor at ..... $.....

.....Hrs. Mason at ..... $.....

.....Hrs. ..... at ..... $.....

.....Hrs. ..... at ..... $.....

.....Builders' Use of Water ..... $.....

..... at ..... $.....

..... at ..... $.....

..... at ..... $.....

..... at ..... $.....

Total $.....

Laf

...or and Material Report Dec 8 1928

49 Warren St 81-83

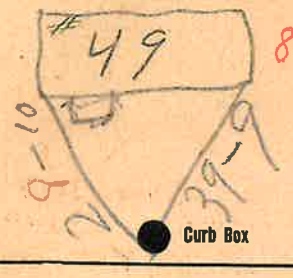

18" Main

Elev. of Main at tap

Gate at ● ● Gate at

● Curb Box

Part of 77-87-