LABOR AND MATERIALS

1 Copper / Lead } Connection 2" ..... $

1 Curb { Cock / ~~Valve~~ / ~~T. S. & V.~~ } 2 in. ..... $

1 Service box { Short 3½ x 4½ / Long 4½ x 5½ / Buff or Rdway } ..... $

~~3~~ 32 Ft. 2 in. { Copper / ~~G. I.~~ / ~~C. I.~~ } Pipe at ..... $

..... Nipples ..... in. at ..... $

..... Bushings ..... to ..... in. at ..... $

Red'g / Inc'g } Coupl'gs ..... to ..... in. at ..... $

..... Union ..... in. at ..... $

..... Meter ..... in. at ..... $

..... Lead Joints at ..... $

..... Compound Joints at ..... $

..... Maintenance Foreman ..... $

..... Hrs. Water Maint. Man—1 at ..... $

..... Hrs. Water Maint. Man—2 at ..... $

..... Hrs. Garage Foreman ..... at ..... $

..... Hrs. Labor— ..... at ..... $

..... Hrs. Compressor at ..... $

..... Compensation Ins. at $ ..... per C ..... $

..... Trucking ..... $

..... Pav't Patch ..... $

..... $

..... $

..... $

..... O'head ..... $

..... $

97
99
Warren St. / ~~Pl.~~ Ave. No. 101

Name of Owner

Saint James Apt.

Labor and Mat'l. Report Oct 11 1927

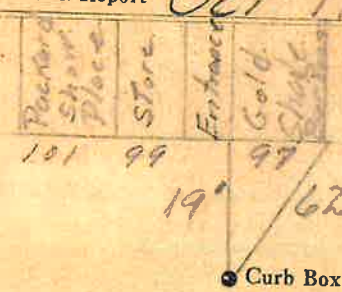

10" Main Elev. of Main at tap 5'

Gate at • • Gate at

2" Copper 32' 2" to main

• Curb Box

TAX ID# 310.5-4-6

L M—5C—2-1-54