LABOR AND MATERIALS

Copper Lead — Connection _____ $_____

Curb — Cock / Valve / T. S. & V. _____ in. _____ $_____

Service box / Old returned — Short 3½ x 4½ / Long 4½ x 5½ / Buff or Rdway _____ $_____

_____ Ft. _____ in. — Copper / G. I. / C. I. Pipe at _____ $_____

_____ Nipples _____ in. at _____ $_____

_____ Bushings _____ to _____ in. at _____ $_____

Red'g / Inc'g Coupl'gs _____ to _____ in. at _____ $_____

_____ Union _____ in. at _____ $_____

_____ Meter _____ in. at _____ $_____

_____ Lead Joints at _____ $_____

_____ Compound Joints at _____ $_____

_____ Maintenance Foreman _____ $_____

_____ Hrs. Water Maint. Man—1 at _____ $_____

_____ Hrs. Water Maint. Man—2 at _____ $_____

_____ Hrs. Garage Foreman _____ at _____ $_____

_____ Hrs. Labor— _____ at _____ $_____

_____ Hrs. Compressor at _____ $_____

_____ Compensation Ins. at $_____ per C _____ $_____

_____ Trucking _____ $_____

_____ Pav't Patch _____ $_____

_____ $_____

_____ $_____

_____ $_____

_____ O'head _____ $_____

$_____

St. ~~Pl.~~ Ave. No. 109

Warren

Name of Owner

Ford Garage Co.

~~Labor and Mat'l. Report~~ Measured in Sept. 26 1968

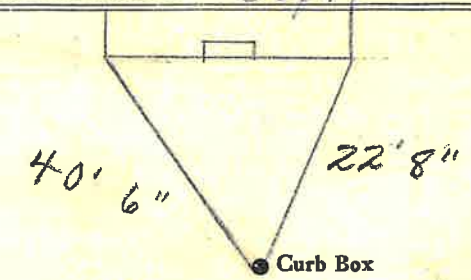

10" Main

Elev. of Main at tap 4½'

Gate at ●

● Gate at

● Curb Box

TAX ID # 310.5-4-4

LSM—5C—6-1-67